


- NOTES.
1. THIS DRAWING TO BE READ IN CONJUNCTION WITH ALL OTHER RELEVANT ARCHITECTS AND ENGINEERS DRAWINGS.
 2. ALL INDICATED CLEADER ANGLES ARE SUPPLIED BY SNASHALL STEEL FABRICATIONS FOR FITTING BY OTHERS.
 3. THIS DRAWING IS FOR INFORMATION ONLY AND DOES NOT FORM PART OF THE CONTRACT DOCUMENTS.

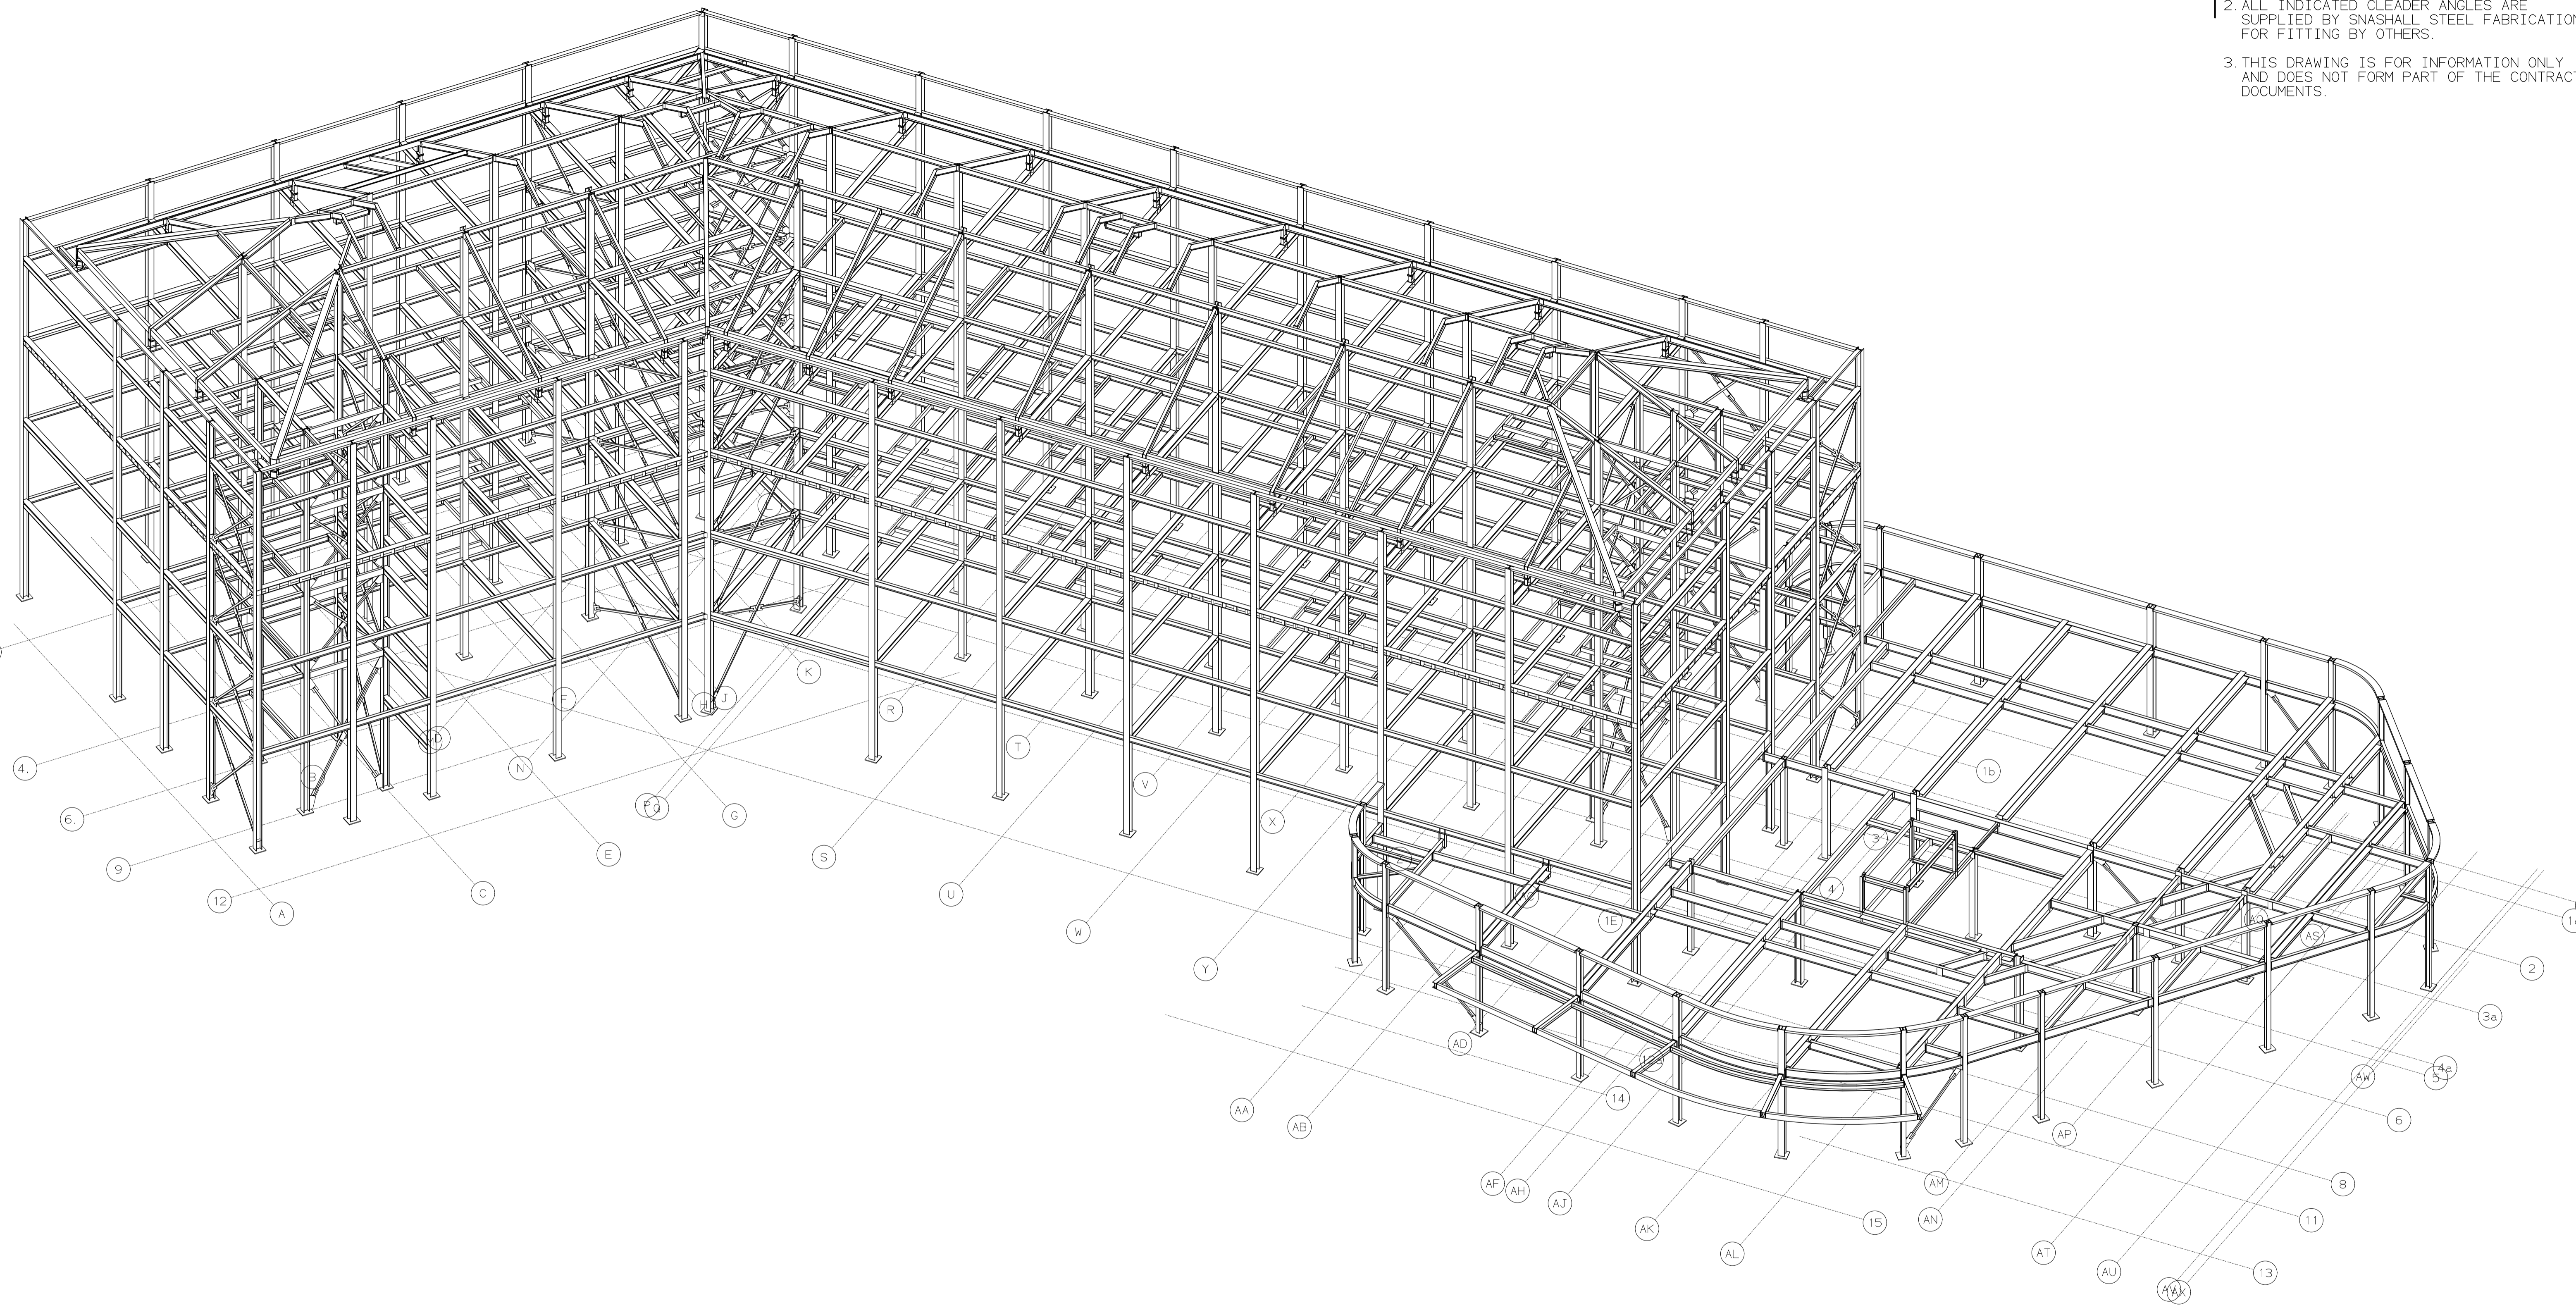

AB1	19/03/13	ISSUED AS BUILT
C1	09/04/12	ISSUED FOR CONSTRUCTION
P1	26/03/12	ISSUED FOR APPROVAL
REV 'N	DATE	DESCRIPTION
SNASHALL STEEL FABRICATIONS Co.Ltd. Pulham Business Park, Pulham, Dorchester, Dorset, DT2 7DX. Tel: 01300-345588 Fax: 01300-345533 www.snashallsteel.co.uk e-mail: ian@snashallsteel.co.uk		
DRAWN	ARK	SCALE N.T.S.
H4H Accom Block		
CLIENT	Interserve	
SITE	Devonport	
ISOMETRIC		
CONTRACT No.	2015	ISSUED
DRAWING No.	GA12	REVISION AB1

AS BUILT