


THIS DRAWING SHALL ONLY BE USED FOR THE INTENDED PURPOSE AND ONLY WRITTEN DIMENSIONS USED

NOTES.

- 1. THIS DRAWING TO BE READ IN CONJUNCTION WITH ALL OTHER RELEVANT ARCHITECTS AND ENGINEERS DRAWINGS.
- 2. ALL INDICATED CLEARER ANGLES ARE SUPPLIED BY SMASHALL STEEL FABRICATIONS FOR FITTING BY OTHERS.
- 3. THIS DRAWING IS FOR INFORMATION ONLY AND DOES NOT FORM PART OF THE CONTRACT DOCUMENTS.

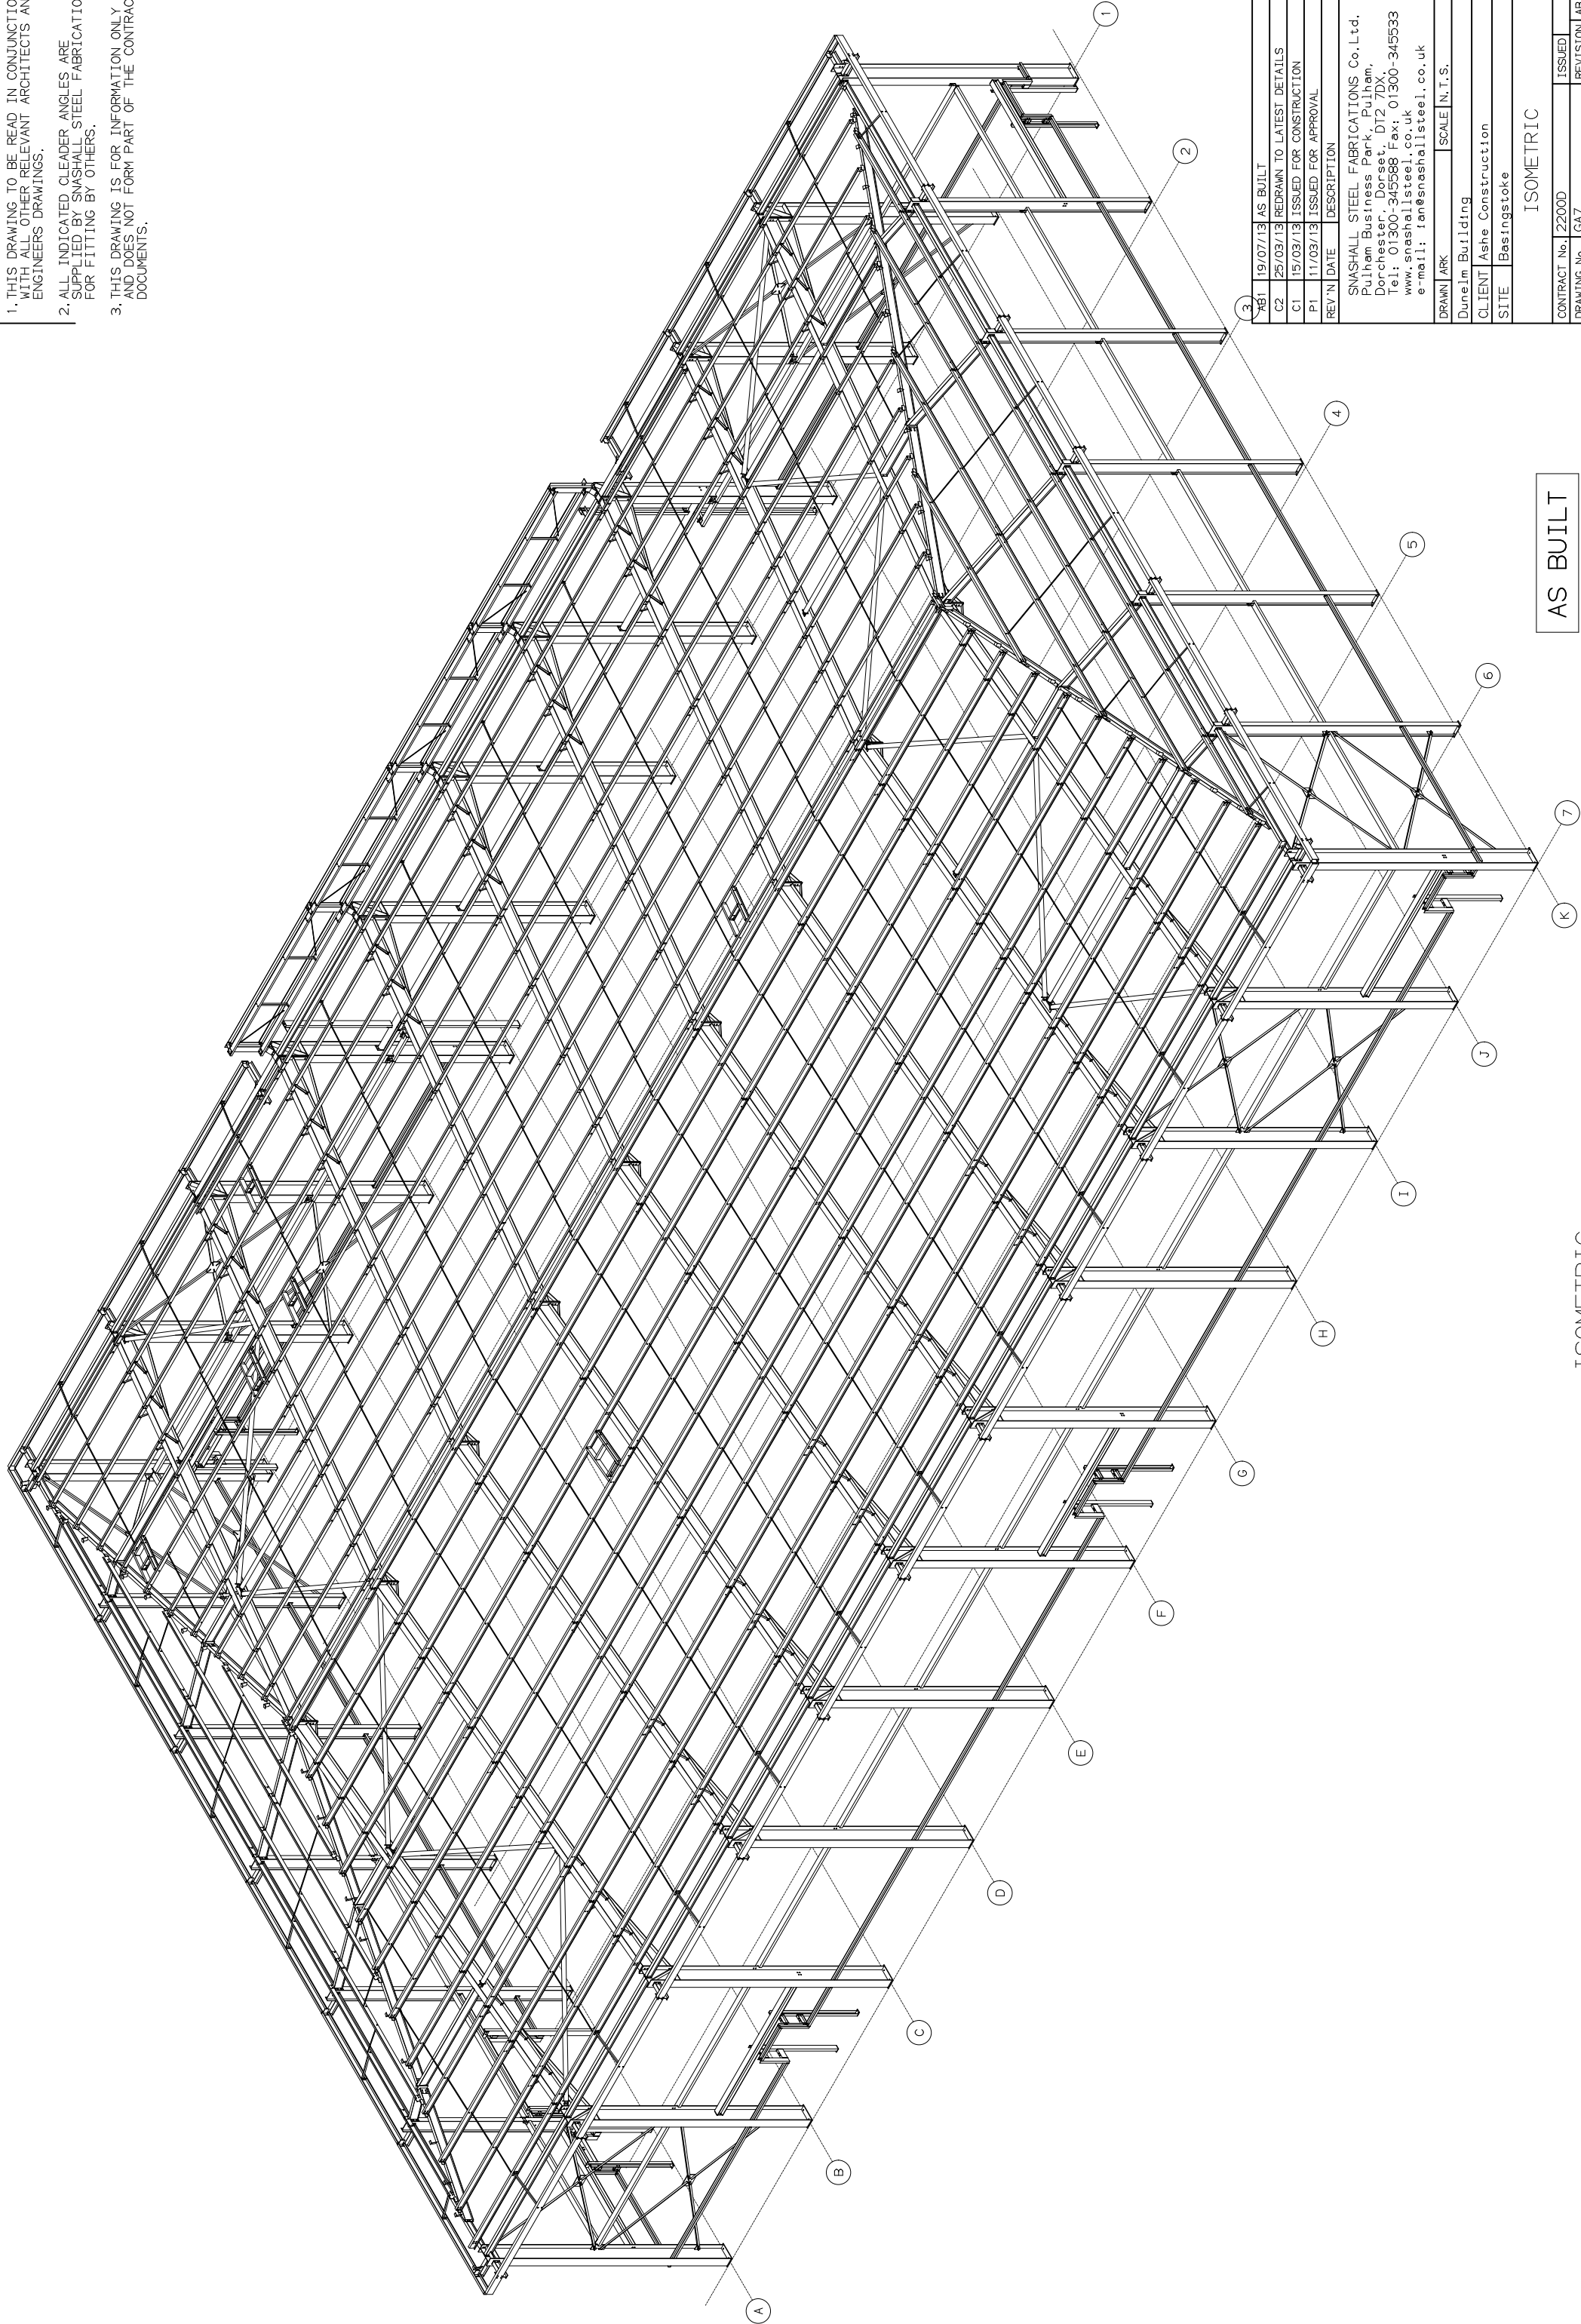

REV	DATE	DESCRIPTION
AB1	19/07/13	AS BUILT
C2	25/03/13	REDRAWN TO LATEST DETAILS
C1	15/03/13	ISSUED FOR CONSTRUCTION
P1	11/03/13	ISSUED FOR APPROVAL

SMASHALL STEEL FABRICATIONS Co. Ltd.  
 Pulham Business Park, Pulham,  
 Dorchester, Dorset, DT2 7DA,  
 Tel: 01300-345588 Fax: 01300-345533  
 www.smashallsteel.co.uk  
 e-mail: info@smashallsteel.co.uk

DRAWN	ARK	SCALE	N.T.S.
DuneIm Building			
CLIENT	Ashe Construction		
SITE	Basingstoke		

ISOMETRIC	
CONTRACT No.	12200D
DRAWING No.	GA7
ISSUED	
REVISION	AB1

AS BUILT

ISOMETRIC